



# Skybridge - Escalator L2 Works

**Note:**  
All dimension are indicative and may vary throughout the project to meet the projects changing requirements

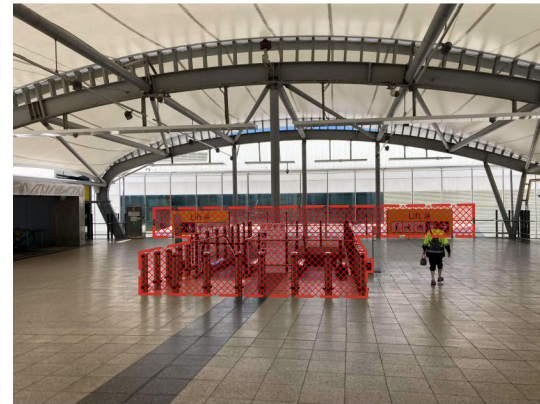

VIEW A

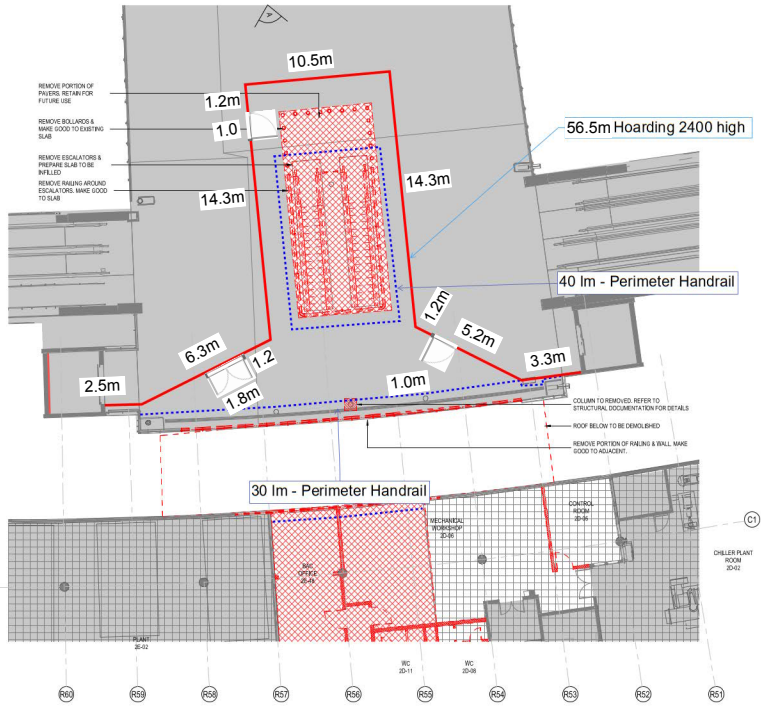

1 LEVEL 2 DEMOLITION PLAN  
Scale: 1:100

Symbol	Type
[Red line]	Vehicle Impact Resistant and Hoarding/Anti Gaw
[Red line]	Hoarding (1) 2400 high
[Green line]	Hoarding (2) Floor to Ceiling
[Blue line]	Hoarding (3) SEZ Security Wall
[Yellow line]	Hoarding (4) 12/24 Security Hoarding
[Blue line]	Hoarding (7) 7m Internal Engineered
[Blue line]	Scaffolding/formwork support
[Blue line]	Perimeter handrail/edge protection
[Yellow line]	Scaffolding perimeter/containment 5 board/2 board hop up
[Yellow line]	10 kPa Gantry/Loading Bay
[Blue line]	Scaffold Stretcher Stair
[Red dashed line]	Temporary Fence
[Red solid line]	Impact Attenuator

MANAGING CONTRACTOR




BRISBANE AIRPORT CORPORATION  
DOMESTIC TERMINAL BUILDING  
SECURITY UPGRADE PROJECT

Name: Hoardings - Mark Ups and Project Staging  
NO. LLC-19057-PM-PLN-0005  
Date: 5/05/2023  
REV: 3

# Skybridge - Escalator L1 Works Phase 1

**Note:**  
All dimension are indicative and may vary throughout the project to meet the projects changing requirements

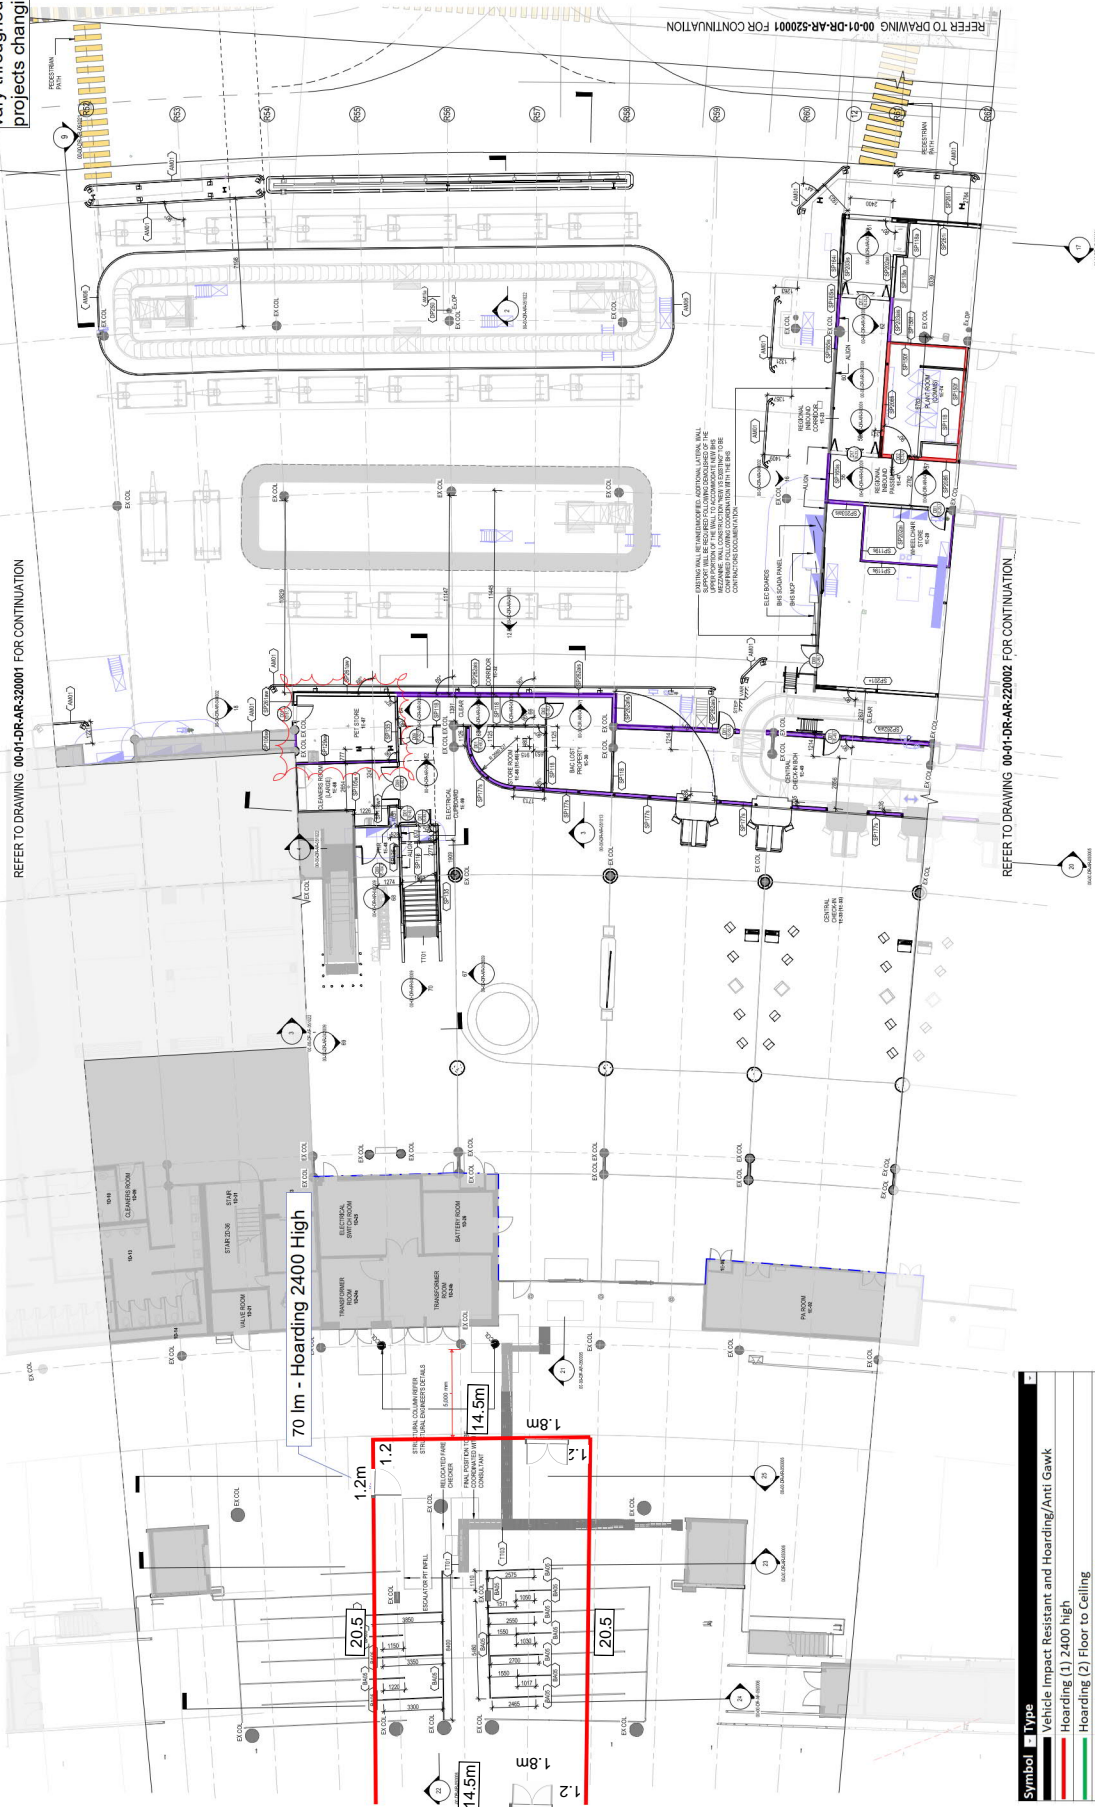

Symbol	Type
[Red outline]	Vehicle Impact Resistant and Hoarding/Anti Gawck
[Green outline]	Hoarding (1) 2400 High
[Blue outline]	Hoarding (2) Floor to Ceiling
[Yellow outline]	Hoarding (3) SEZ Security Wall
[Purple outline]	Hoarding (4) 12/24 Security Hoarding
[Orange outline]	Hoarding (7) 7m Internal Engineered
[Light Blue outline]	Scaffolding/formwork support
[Light Green outline]	Perimeter handrail/edge protection
[Light Purple outline]	Scaffolding perimeter/containment 5 board/2 board hop up
[Light Orange outline]	10 kPa Gantry/Loading Bay
[Light Yellow outline]	Scaffold Stretcher Stair
[Light Green outline]	Temporary Fence
[Light Blue outline]	Impact Attenuator